Monday, 07/07/2008 4:23:02 PM

Wear:

Julie Lecoca

### **Process Sheet**

Customer

: CU-DAR001 Dart Helicopters Services

Job Number **Estimate Number**  : 40341

: 10256

P.O. Number

: 07/07/2008 This Issue : NC

Prsht Rev. First Issue

: 11 : 39404 Type

S.O. No. :

: MACHINED PARTS

**Part Number** 

**Drawing Name** 

: D22303

**Drawing Number** 

. D2230 REV F

: MOUNTING LUG

**Project Number Drawing Revision**  : N/A

Material

Due Date

: 30/07/2008

Qty:

200 Um:

Each

Written By

**Previous Run** 

Checked & Approved By

Comment

: Est D 00.05.18 Added inspection level 8, and removed P/O for

EC powder coat

**Additional Product** 

Job Number:



Seq. #:

**Machine Or Operation:** 

**Description:** 

1.0

D2423

Lug Extrusion

Comment: Qty.:

0.0717 f(s)/Unit Total:

14.3430 f(s)

Lug Extrusion

D2423

Batch: 1833310

2.0

BAND SAW

BAND SAW

Comment: Band Saw

Cut D2423 extrusion to 0.82"

Batch:

HAAS

HAAS CNC VERTICAL MACHINING #1

3.0

CL08/07/08

Comment: HAAS CNC VERNICAL MACHINING #1

Machine per folio D2230-3

Check for crack while loading into the machine.

Irwy 12230 Reu F

INSPECT PARTS AS THEY COME OFF MACHINE

Comment: INSPECT PARTS AS THEY COME OFF MACHINE

courts

5.0

Comment: SECON

## **Dart Aerospace Ltd**

W/O:		WORK ORDER CHANGES								
DATE	STEP	PROCEDURE CHANGE	Ву	Date	Qty	Approval Chief Eng / Prod Mgr	Approval QC Inspector			
		-,-								
ì										

Part No:	PAR #:	Fault Category:		NCR: Yes	No	DQA:	Date:	<del></del>
	•		`	QA: N	/C C	losed:	Date:	

NCR:		WORK ORDER NON-CONFORMANCE (NCR)										
		Descr	iption of N	^		Corrective	e Action	Section B	_	Verification	Annewal	Approval
DATE	STEP		Section A		Initial Chief Eng	Actio	on Descri Chief Eng	ption		Section C	Approval Chief Eng	QC Inspector
				÷	,		÷					
				,	9	<del>-</del>				,		
•		•		ve					-			
- Y	,										•	
								de la companya de la				<u> </u>
								ť				
		·	.,				<del></del>				•	
				4		, <b>.</b>						
		,	\$17 m						.*		- 16: -	
		**		1			÷.	2		1/1/		

NOTE: Date & initial all entries

Date: Monday, 07/07/2008 4:23:02 PM User: Julie Lecocq **Process Sheet Drawing Name: MOUNTING LUG** Customer: CU-DAR001 Dart Helicopters Services Job Number: 40341 Part Number: D22303 Job Number: Seq. #: **Machine Or Operation:** Description : SMALL & MEDIUM FAB RESOURCE 1 SMALL FAB 1 Comment: SMALL & MEDILM FAB RESOURCE 1 Tumble and deburr rough edges after tumbling 7.0 HAND FINISHING RESOURCE #1 Comment: HAND FINISHING RESOURCE #1 Acid etch and Alodine as per QSI 005 4.1 QC5 8.0 Comment: INSPECT WORK TO CURRENT STEP 9.0 POWDER COATING POWDER COATING M1 108523 Comment: POWDER COATING Powder Coat Gloss White (ref. 4.3.5.1) per Dart QSI 005 4.3 START TIME: **OVEN TEMPERATURE:** FINISH TIME: 10.0 QC3 INSPECT POWDER COAT/CHEMICAL Comment: INSPECT POWDER COATINSPECT POWDER COAT PACKAGING 1 11.0 PACKAGING RESOURCE #1 Comment: PACKAGING RESOURCE #1 Identify and Stock Location: 12.0 QC21 FINAL INSPECTION/W/O RELEASE Comment: FINAL INSPECTION/W/O RELEASE Job Completion

Mar.

## **Dart Aerospace Ltd**

W/O:		WORK ORDER CHANGES									
DATE	STEP	PROCEDURE CHANGE	Ву	Date	Qty	Approval Chief Eng / Prod Mgr	Approval QC Inspector				
	į										
_							<u></u>				

Part No:	_ PAR #:	Fault Category:	NCR	t: Yes	No	DQA:	Date:	
			•	QA: N	VC CI	osed:	Date:	

NCR:		WORK ORDER NON-CONFORMANCE (NCR)									
		Description of NC		Corrective Action Section B		Verification	Approval	Approval			
DATE	STEP	Section A	Initial Chief Eng	Action Description Chief Eng	Sign & Date	Section C	Chief Eng	QC Inspector			
					_						

NOTE: Date & initial all entries

Work Order:	4034
Part Number:	D2230-3
	Page 1 of 1

#### FIRST ARTICLE INSPECTION CHECKLIST

X	First Article		Prototype
---	---------------	--	-----------

Drawing	Tolerance	Actual	Accept	Reject	Method of	Comments
Dimension		Dimension			Inspection	
4.450	+/-0.010					
0.413	+/-0.010					
0.306	+/-0.010					-
3.700	+/-0.010					
0.750	+/-0.010					
Ø0.257	+0.005/-0.000					
0.375	+/-0.010					
R1.200	+/-0.010					
0.100 x 45°	+/-0.010		1			
						<u>-</u> ү <u></u>
			/ W			
3.0		<b>/</b>	\ \V			
			,		,	
<del></del>						<del>.</del>
	/					
		- (				
	/				8	
			0	1 (		
			1 8	181	<b>/</b>	
					,	
						*


Measured by:	Audited by:	Prototype Approval:	N/A .
Date:	Date:	Date:	


Rev	Date	Change	Revised by	Approved
Α	03.11.11	New Issue	KJ/RF	· 4



DESIGN		P	DRAWN BY	DART AEROSPACE LTD HAWKESBURY, ONTARIO, CANADA							
	CHEC	KED	APPROVED	DRAWING NO.					REV.	F	
		#	**	D2230				SHEET	1 OF	2	
	DATE			TITLE					SCA	LE	
	99.1	2.13		MOUNTING LU	G				1	1:1	
	С		94.03.30	RE-DESIGN							
	D		95.01.04	RE-DESIGN							
	£		95.01.04	RE-DESIGN							
	۴		99 12 13	PEDESIGN:	21 200	MAC	D1 1/	20			

## RELEASED

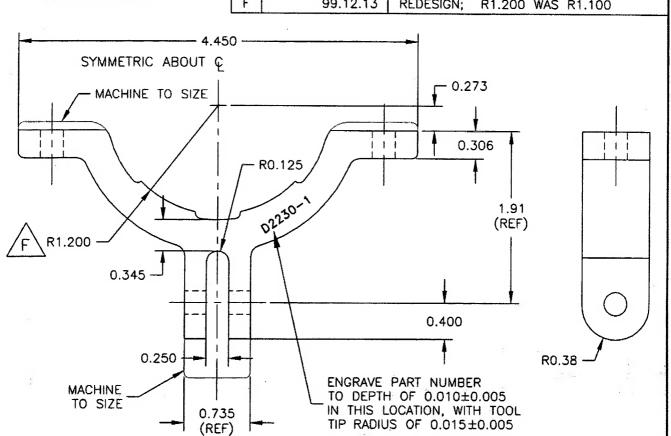

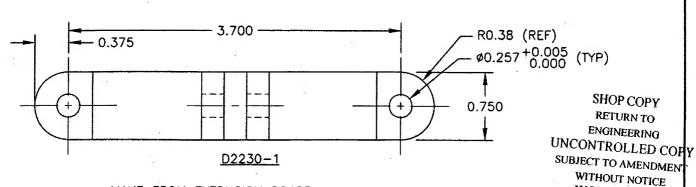

MAKE FROM EXTRUSION D2423 BREAK ALL EDGES 0.000-0.015

FINISH: ACID ETCH AND ALODINE PER DART QSI 005 4.1


POWDER COAT WHITE (4.3.5.1) PER DART QSI 005 4.3 TOLERANCES ARE PER DART QSI 018 UNLESS OTHERWISE NOTED






DESIGN	DRAWN BY	DA	RT AEROSPACE HAWKESBURY, ONTARIO, CANA	
CHECKED	APPROYED	DRAWING NO.		REV. F
#	#	D2230	•	SHEET 2 OF 2
DATE		TITLE		SCALE
99.12.13		MOUNTING	LUG	1:1

# RELEASED

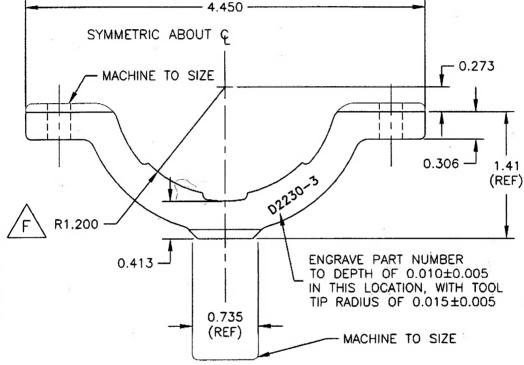

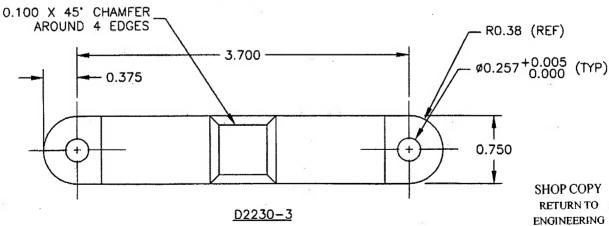

MAKE FROM EXTRUSION D2423 BREAK ALL EDGES 0.000-0.015

FINISH: ACID ETCH AND ALODINE PER DART QSI 005 4.1
POWDER COAT WHITE (4.3.5.1) PER DART QSI 005 4.3
TOLERANCES ARE PER DART QSI 018 UNLESS OTHERWISE NOTED

work order no 40341

UNCONTROLLED COPY SUBJECT TO AMENDMENT

WITHOUT NOTICE



#### **ORDER CONFIRMATION**

Order No.:

6711

Date:

Jul 10, 2008

Page: Ship Date:

Jul 25, 2008

Sold To:

Dart Aerospace Ltd. Att. Linda Lacelle 1270 Aberdeen Street Hawkesbury, Ontario K6A 1K7 Ship To:

Dart Aerospace Ltd. Att. Linda Lacelle 1270 Aberdeen Street Hawkesbury, Ontario K6A 1K7

Business No.: 867 061 723

Ordered	Unit	Description		:::::::::::::::::::::::::::::::::::::::		Unit Price	Amount
200	Each	D2230-3	Mounting Lug			10.40	2,080.00
							•
		Terms: 2%/	10. Net 30				
		Delivery: /	As above				
		Shipped By	our truck				
							·
	,						
						Freight	0.00
Thank you for your	orderi					GST 6 %	104.00
					To	tal Amount	2,184.00



### **CERTIFICATE OF CONFORMITY**

SOLD TO:

SHIPPED TO:

Dart Aerospace Ltd. 1270 Aberdeen Street Hawkesbury, Ont.

same

K6A 1K7

QUANTITY

PART NUMBER

PART NAME

P.O. NUMBER

220

D2230-3

Mounting Lug

MATERIAL: supplied by DART D2423 B33310

6711

We herely certify that the above parts were made in conformance with applicable drawings.

METEC | Ietal Technology Inc.

Denise Fobinson

∀ankleeł Hill, August 1, 2008